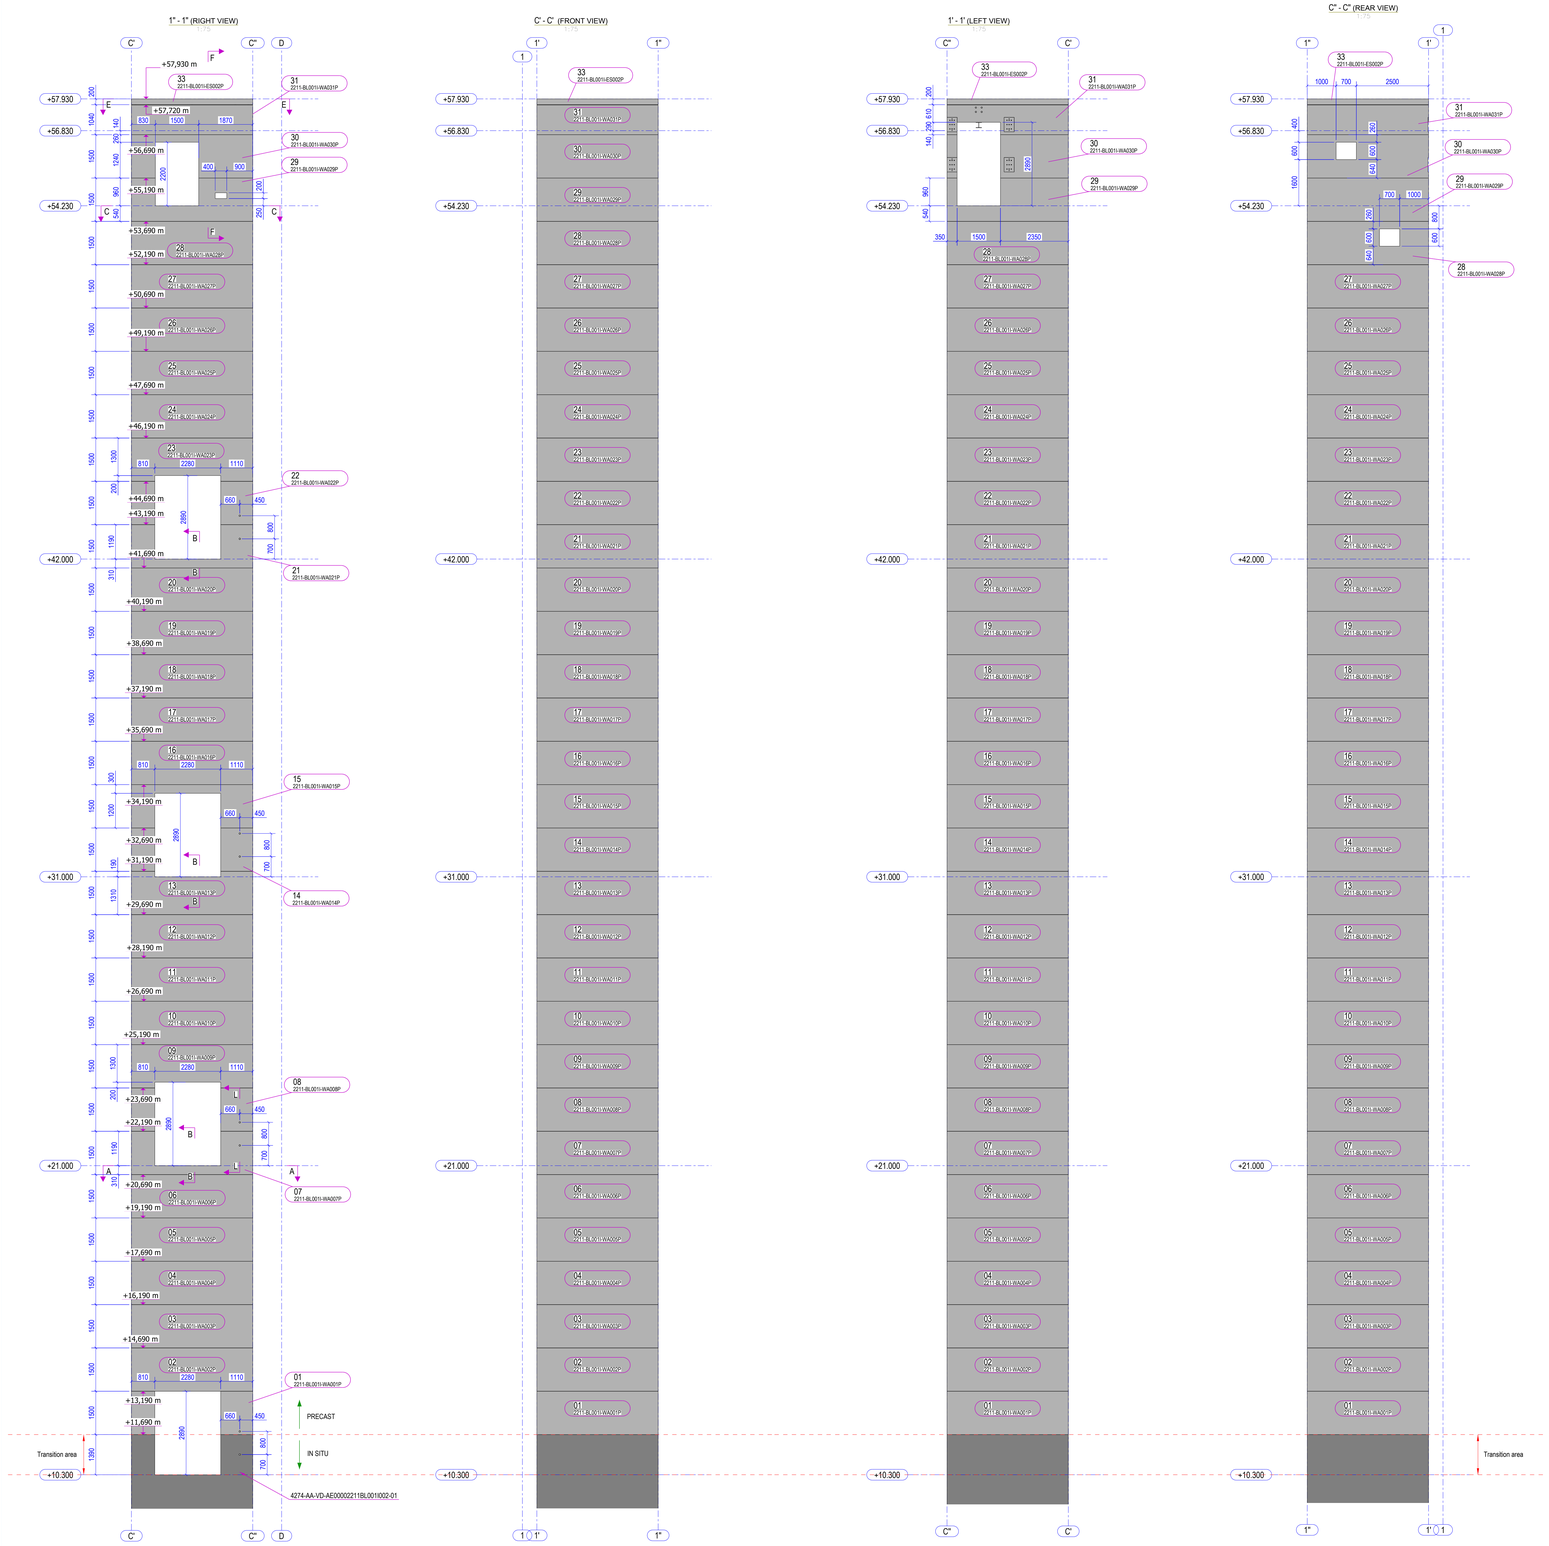

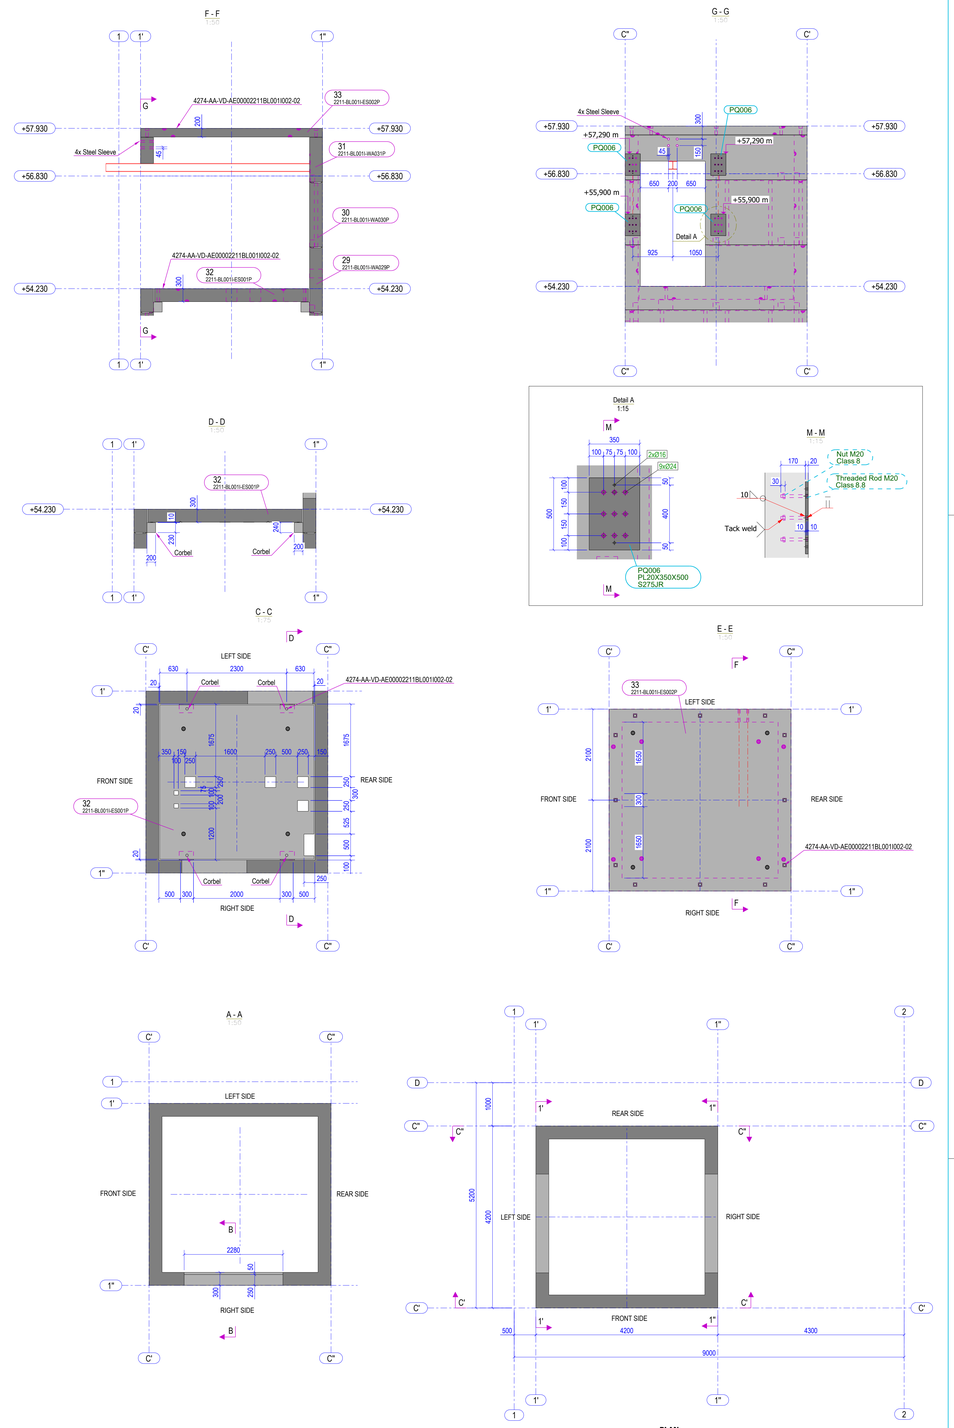

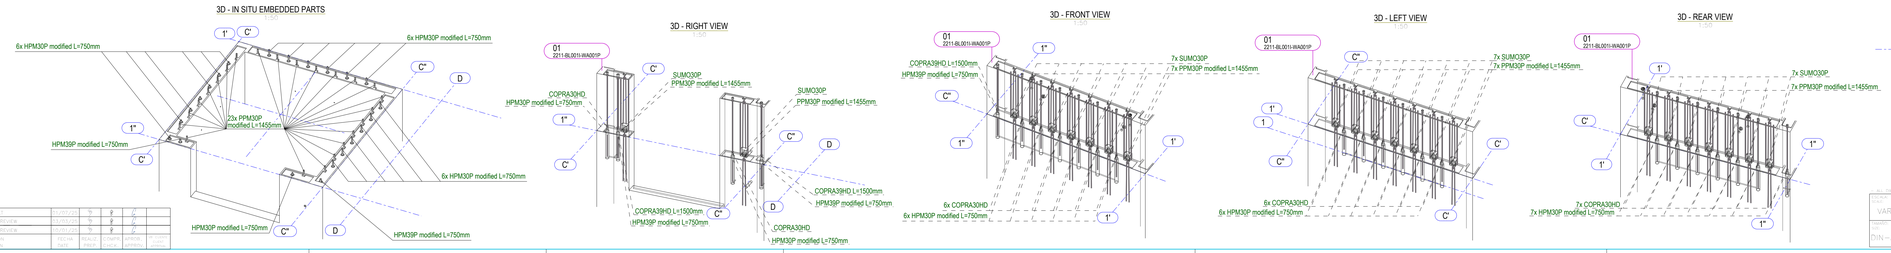

03	AS BUILT	31/07/25	N	R	R
02	ISSUED FOR REVIEW	01/01/25	N	R	R
01	ISSUED FOR REVIEW	20/01/25	N	R	R
REV	DESCRIPTION	DATE	DRAWN	CHECK	APPROV.

Tekla Structures

PROJECT	AREA 2211 - EXTRUSION (PP AND PE) + 2211-BL001
DRAWING	PRECAST LIFT SHAFT SHOP DRAWING OF BC PRECAST ELEMENTS EXTRUSION BUILDING (PP AND PE)
CONTRACT NO.	VAR.
DRAWING NO.	4274-AA-VD-AE00002211BL0010002
SCALE	DIN-A0
DATE	4001008

ALL DIMENSIONS ARE IN MILLIMETERS UNLESS OTHERWISE NOTED

OWNER	REPSOL POLYMERS
LOCATION	CENTRO SINES INDUSTRIAL COMPLEX
CONTRACTOR	Tecninont
DRAWING NO.	1-P-W4058-0019-00-0000-A-0-004
REV.	02

CONTRACT NUMBER	CONTRACT TITLE	CONTRACT STAMP		
4274	WORK TITLE	No. Comment	Signature	Date

Engineering Manager Approval
Reviewed with no comment
Reviewed with comment
Resubmit

CONTRACTOR Company Name	Signature	Date	CONSULTANT Company Name	Signature	Date

Engineering Discipline Approval
A: Accepted
AC: Accepted with Comment, Resubmit
CR: Contractor - Required no Resubmit
CN: Not Required, Resubmit

CONSULTANT Company Name: The Technical Office of Ing. Antonio Verdasca
Signature:
Date:

WP No.	4274-AA-WP-0000004
WP Description	Extrusion Precast LPL Shaft
Work Pack Rev.	NA
Work Pack Type	PRECAST CONCRETE

VERDASCA GROUP

Tecninont

REVISION	DATE	PREPARED	CHECKED
00	01/01/25	N. Ferrante	A. Verdasca